
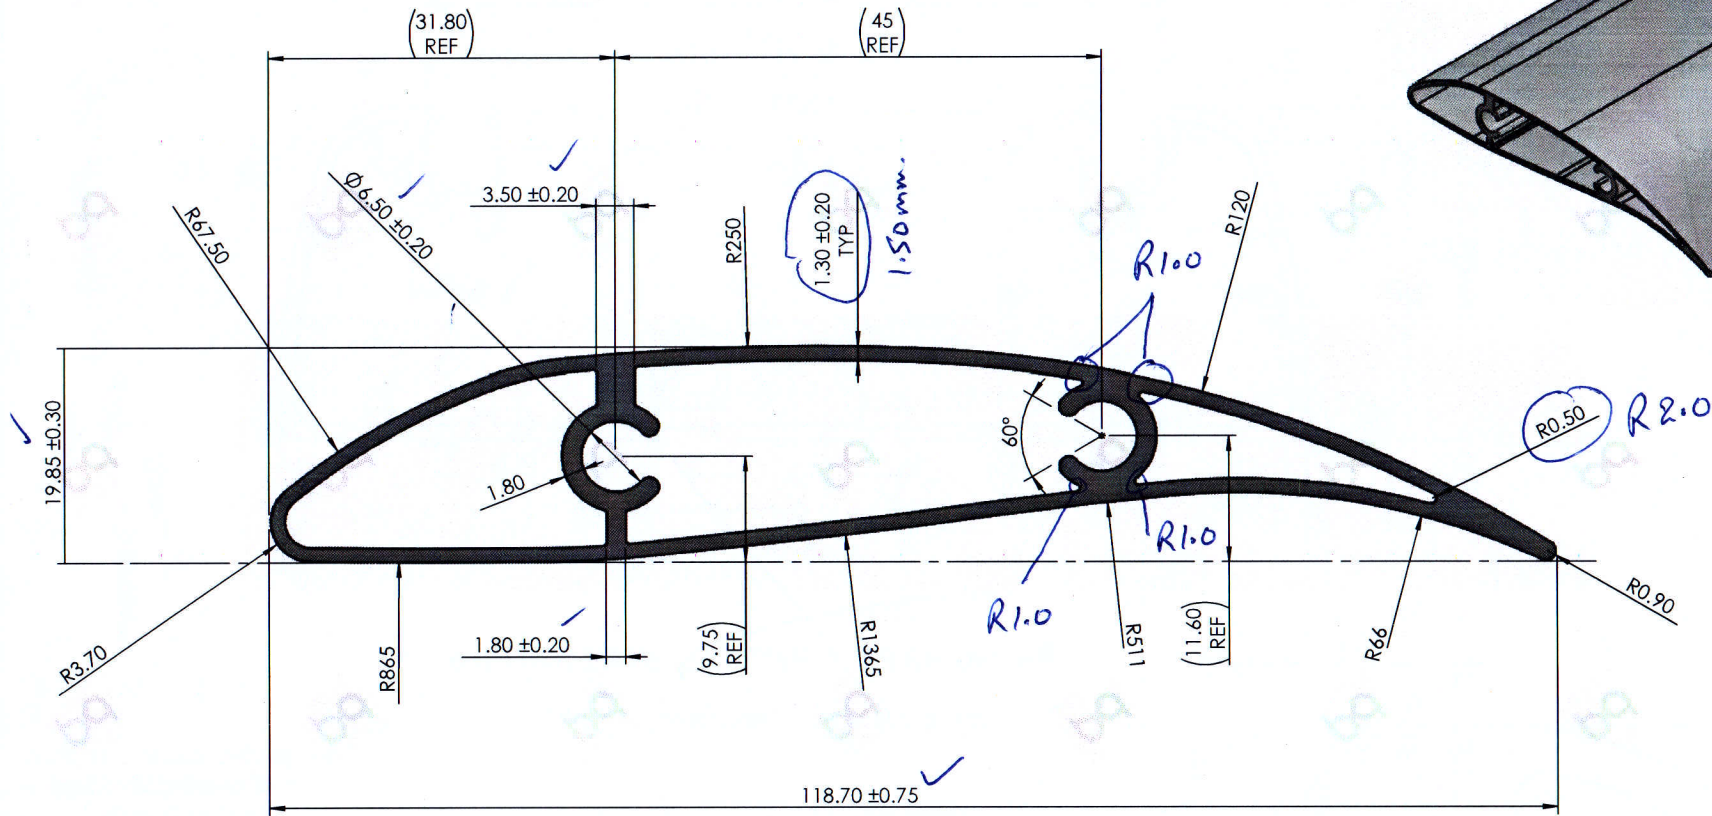


000858

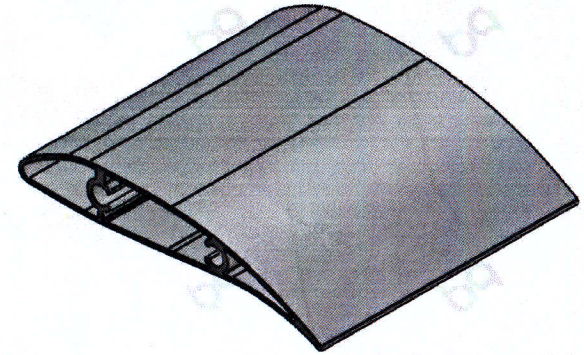

→ Due to uneven surface, mark may be appear on joint of Radius. ~~R1.0~~

→ A 2D/3D Drawing or Sample Required to Develop Counter Drawing

CUSTOMER FILL THIS:- Only dimension check purpose, Feasibility has not been done. Please mark the critical dimensions as circle and please provide the fitting attachment of this dies ( at least 4 set )

Please let me know the following detail for new development as given below

1 - Alloy :-  
4 - Material Finish :-

2 - Hardness :-  
5 - Packing standard :-

3 - Cut length :-  
6 - Part application :-

*fresh*  
7/8/23

- NOTES:-**
- UNSPECIFIED CORNER RADIUS = 0.25 mm
  - ALL OTHER GENERAL TOLERANCE WILL BE AS PER IS 3965 (1981) AND IS 6477 (1983) FOR SOLID AND HOLLOW PROFILE RESPECTIVELY.
  - ALL DIMENSIONS ARE IN MM.

TOTAL PERIMETER:- 544.062 mm	
EXTERNAL PERIMETER:- 250.176 mm	
REVISION NO:- 00	REVISION DATE:-
REVISION CHANGE:-	
PART NO. :-	
PART NAME:-	CUT LENGTH:-
DRAWN BY :- RAJU	CHECKED BY:- SHIVAM
APPROVED BY:- ASWANI	

<b>bq</b>		<b>Balaji Aluminium Extrusions Pvt. Ltd.</b>	
		Plot No :- 109, SECTOR-16,HSIIDC, Bahadurgarh,Haryana-124507	
MATERIAL :- 6063-T6	AREA:- 413.653 Sq. mm		
DATE :- 10-04-2023	WT/3660 mm:- 4.08772 Kg		
FINISH:-	BALAJI MODEL NO. :- M-2682		
CUSTOMER:- Aflux	BALAJI DRAWING NO. :-		