



Alloy - 6005T6

Φ02340

GB 5237.1-2017(High Precision)	
Size	Tolerance
≤3	±0.13
>3-10	±0.15
>10-15	±0.17
>15-30	±0.21
>30-45	±0.26
>45-60	±0.31
>60-100	±0.52

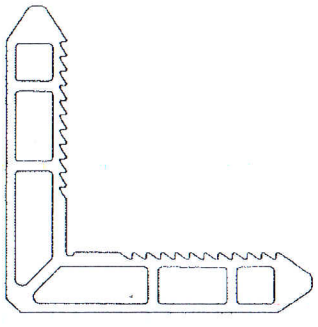

1:1
PROPOSAL DRAWING

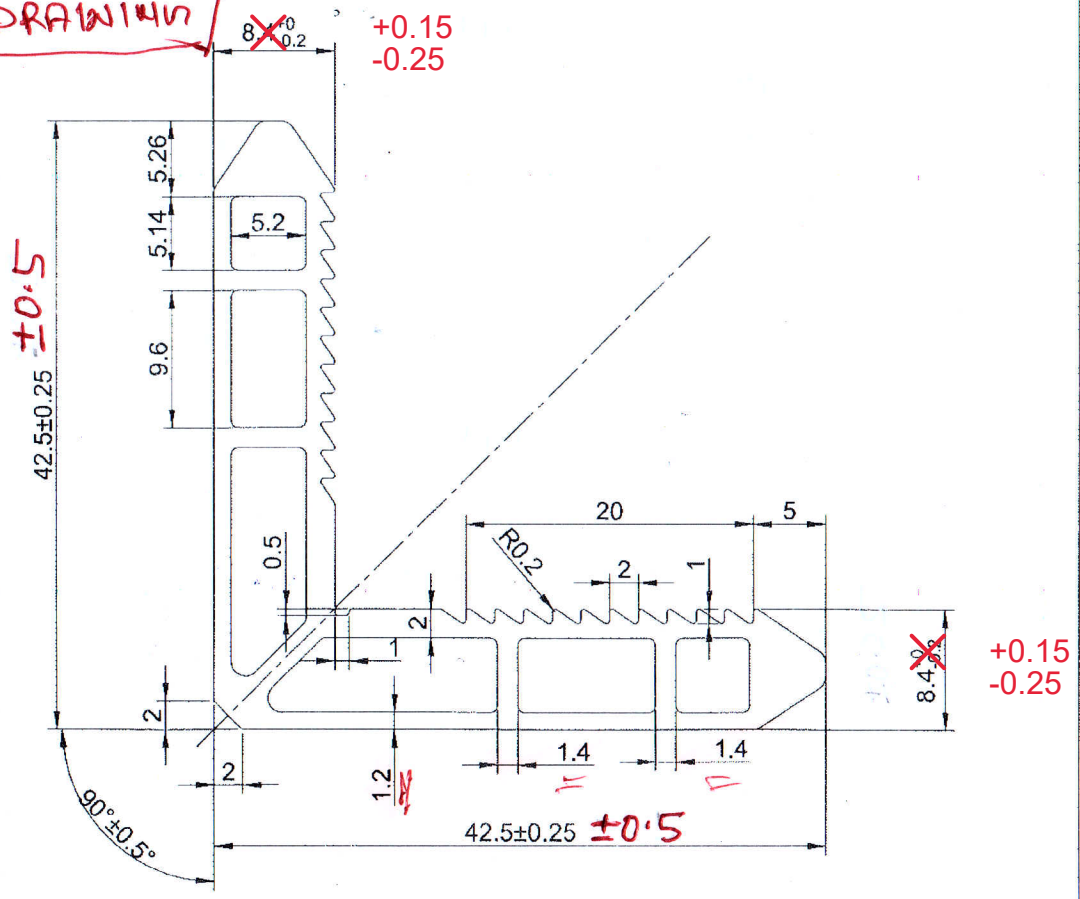

Φ02340

Technical Requirements:
 1. UNSPEC Thickness: ±0.15
 2. Exe Std: GB5237.1-2017 High Precision
 3. Hardness: ≥14HW

Note:
 1. Unspec. wall thickness T ~~0.3~~ mm
 2. Unspec. corners rounded to R ~~0.2~~ mm
 3. ----- is exposed surface.
 4. Perimeter 184.945 mm
 5. Section area 285.184 mm;
 6. Liner density 0.773 kg/m
 7. Circumcircle Φ55 mm

0.3 mm

Machine	Processed	Change	Drawing Number	HHTJL42.5-8.4	NO.
Client	Checked	Date	Discription	Angle Joint	Scale 2:1
Date	Released	Name			Revision A/0
Jiangyin HaiHong New Energy Technology Co., LTD				Material	6005-T6
					Page Total