8687
12034
20619

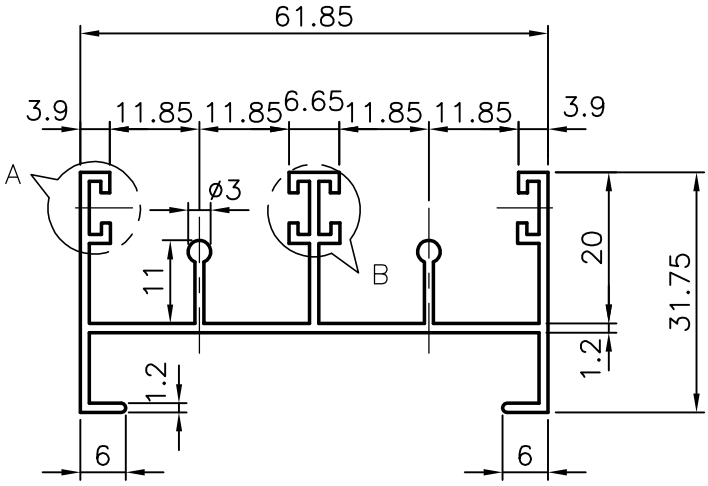

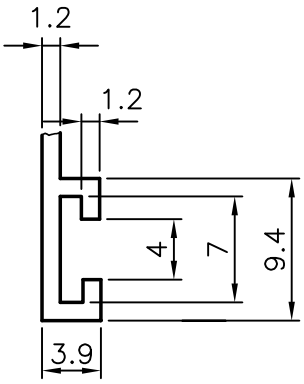

DETAIL 'A'

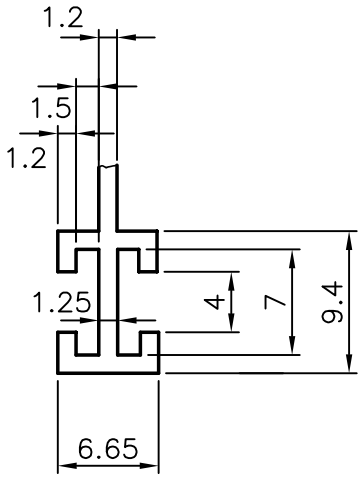

DETAIL 'B'

JINDAL SYMBOL OF QUALITY AN ISO 9002 COMPANY	***JINDAL ALUMINIUM LTD.*** ***BANGALORE–560073 (INDIA)***				NAME	DATE
				DRAWN	S.KUMAR	13–1–84
1. ALL DIMENSIONS ARE IN mm 2. ROUND OFF SHARP CORNERS WITH 0.4mm R 3. TOLERANCES WILL BE AS PER IS : 3965–1981				CHECKED		
				APPROVED		
				SCALE	NTS	
PARTY'S NAME	–			WEIGHT kg/m	0.695	
PARTY'S DRAWING No.	–	FINISH	–	SECTION No.	~~8687~~ 20619	
ALLOY & TEMPER	HE 9 WP	LENGTH:	3658mm	DRAWING No.		
DESCRIPTION	WINDOW SECTION			~~8687~~ 20619		