| |
|---|
| 8704 |
| 12265 |
| 20633 |

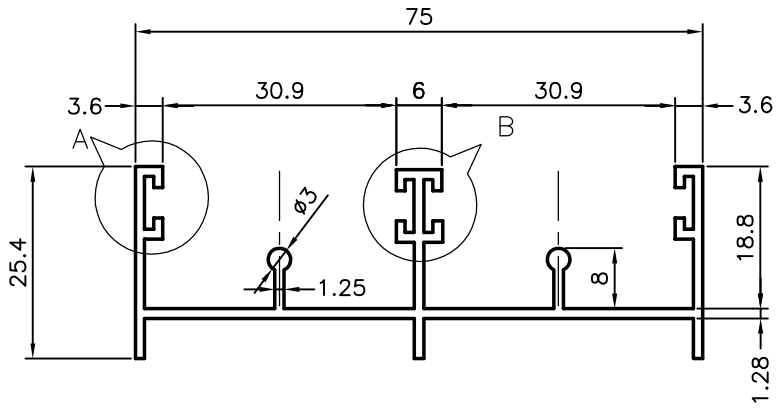


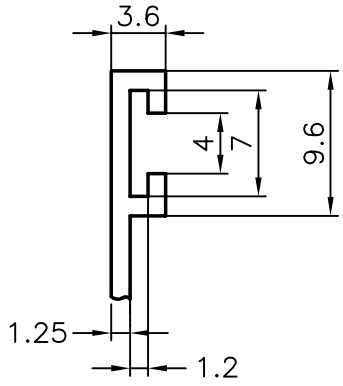


DETAIL AT 'A'

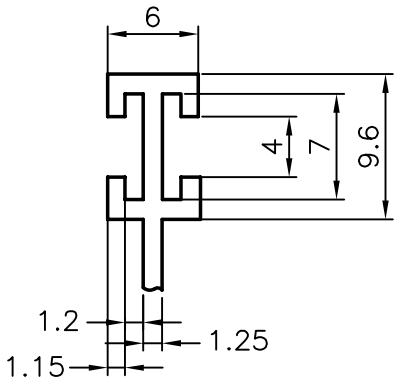


DETAIL AT 'B'

| | | | | | |
|---|---|---|---|---|---|
| JINDAL<br>SYMBOL OF QUALITY<br>AN ISO 9002 COMPANY | ***JINDAL ALUMINIUM LTD.***<br>***BANGALORE–560073 (INDIA)*** | | | NAME | DATE |
| | | | DRAWN | R.D.SHARMA | 5.4.84 |
| 1. All dimensions are in mm.<br>2. Round off all sharp corners with 0.4R.<br>3. Tolerances will be as per IS: 3965–1981. | | | CHECKED | | |
| | | | APPROVED | | |
| | | | SCALE | 1:1 & 2:1 | |
| PARTY'S NAME | | | WEIGHT kg/m | 0.676 | |
| PARTY'S DRAWING No. | | FINISH: AS EXTRUDED | SECTION No. | ~~8704~~ 20633 | |
| ALLOY & TEMPER | HE9WP | LENGTH: 3658mm. | DRAWING No. | | |
| DESCRIPTION | WINDOW SECTION | | ~~8704~~ 20633 | | |