8774
12208
20694

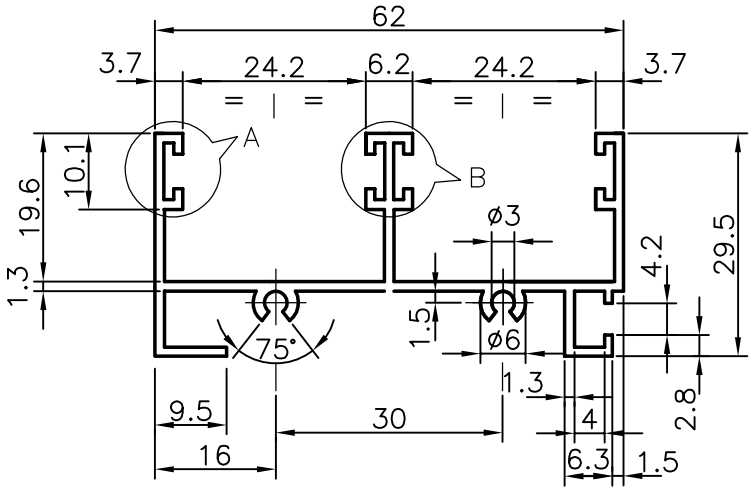

GEN. WALL THICKNESS:– 1.3mm

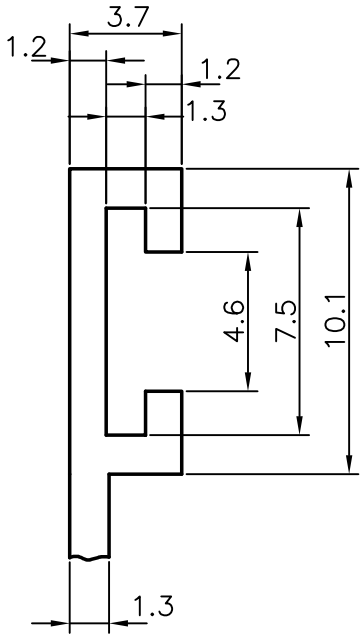

DETAIL–A

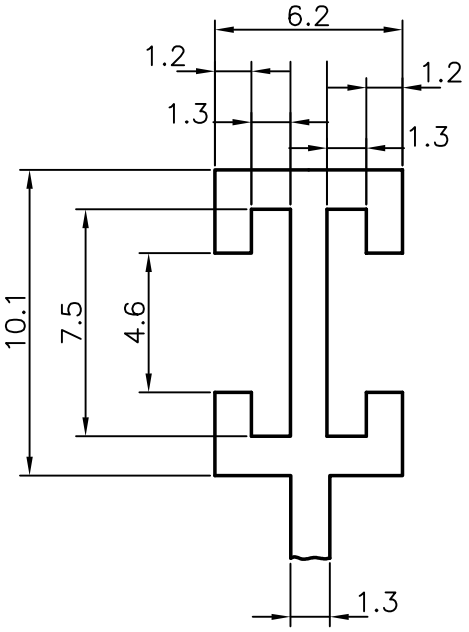

DETAIL–B

NOTE:–

1. ALL DIMENSIONS ARE IN mm.
2. ROUND OFF SHARP CORNERS WITH 0.4mm R.
3. TOLERANCES WILL BE AS PER I.S:3965–1981

JINDAL SYMBOL OF QUALITY AN ISO 9002 COMPANY	JINDAL ALUMINIUM LTD. BANGALORE–560073 (INDIA)				NAME	DATE
				DRAWN	R.D.SHARMA	21–4–86
1. ALL DIMENSIONS ARE IN mM. 2. ROUND OFF SHARP CORNERS WITH 0.4mm R. 3. TOLERANCES WILL BE AS PER IS: 3965–1981.				CHECKED		
				APPROVED		
				SCALE	1:1 & 4:1	
PARTY'S NAME	–			WEIGHT kg/m	~~0.673~~ 0.695	
PARTY'S DRAWING No.		FINISH	–	SECTION No.	~~6773~~ 20694	
ALLOY & TEMPER	HE 9 WP	LENGTH:	3658mm	DRAWING No.	~~6773~~ 20694	
DESCRIPTION	WINDOW SECTION					